


- NOTES:
- THIS DRAWING WAS COMPILED FROM INFORMATION PROVIDED BY WANZEK, UTILIZING INFORMATION FROM THE FOLLOWING FILE LIST.
 - CRM_AvoidanceBuffer_110813.SHX
 - USFWS_WetEase_1012.SHX
 - Wetlands_Poly_102314.SHX
 - Courtenay_TurbineArrayRenumbering_2015_07_15.SHX
 - Courtenay_ALTA_150120.DWG
 - Courtenay_CollectionRecordLines_20161108.SHP
 - Courtenay_AdditionalSurveyCorridor_2015_10_07.kmz
 - THE AERIAL WAS OBTAINED BY ULTEIG.
 - CourtenayAerial_NDStateplane_HarrNAD83_South_IntlFt.SID

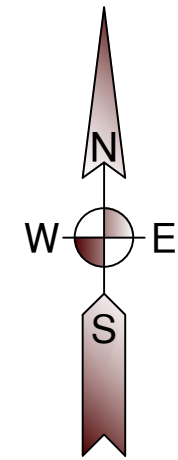

RECORD DRAWING
DRAWINGS ARE BASED UPON
CONSTRUCTION CONTRACTOR REDLINES
WHICH HAVE NOT BEEN FIELD VERIFIED BY
ENGINEER OF RECORD.

LEGEND

- XX WIND TURBINE
- F1 FEEDER 1
- F2 FEEDER 2
- F3 FEEDER 3
- F4 FEEDER 4
- F5 FEEDER 5
- F6 FEEDER 6
- F7 FEEDER 7
- F8 FEEDER 8
- FOC FIBER ROUTE
- SURVEYED CORRIDORS
- RIGHT OF WAY
- NON LEASED
- XJBX JUNCTION BOX
- SPLX-X CABLE SPLICE
- FSX-X FIBER SPLICE
- GRDX-X MID SPAN GROUND
- ACCESS ROADS
- BORE LOCATION [RB X-X]

NO	REVISION						NO	REVISION						REFERENCE DRAWINGS		
	DATE	BY	CHK	ENG	ZONE			DATE	BY	CHK	ENG	ZONE		DWG NO.	MANUFACTURER	DESCRIPTION
A	10/12/2015	MJ	JH	BG												
0	01/22/2016	AS	JH	BG												
1	02/10/2016	CL	JH	BG												
2	06/07/2016	BG	JH	BG												
3	12/05/2016	GP	JH	BG												
4	01/06/2017	GP	JH	BG												

Xcel Energy
NORTHERN STATES POWER
COURTENAY WIND - COLLECTION SYSTEM
STUTSMAN COUNTY, NORTH DAKOTA

DWN: MJ	DATE:01/22/2016	CHK:	DATE:
ENG: BG	DATE:01/22/2016	CHK:	DATE:
PM: BD	DATE:01/22/2016	PROJ. NO: 121901101	
APVD:	DATE:	SCALE:NONE	

THIS MAP/DOCUMENT IS A TOOL TO ASSIST EMPLOYEES IN THE PERFORMANCE OF THEIR JOBS. YOUR PERSONAL SAFETY IS PROVIDED FOR BY USING SAFETY PRACTICES, PROCEDURES, AND EQUIPMENT AS DESCRIBED IN THE SAFETY TRAINING PROGRAMS AND MANUALS.

ENERGY SUPPLY
ENGINEERING & CONSTRUCTION

UNIT 0
FEEDER ROUTING DIAGRAM
SECTION 29, T143N, R62W

NH-271536-38

REV
4